APPENDIX C

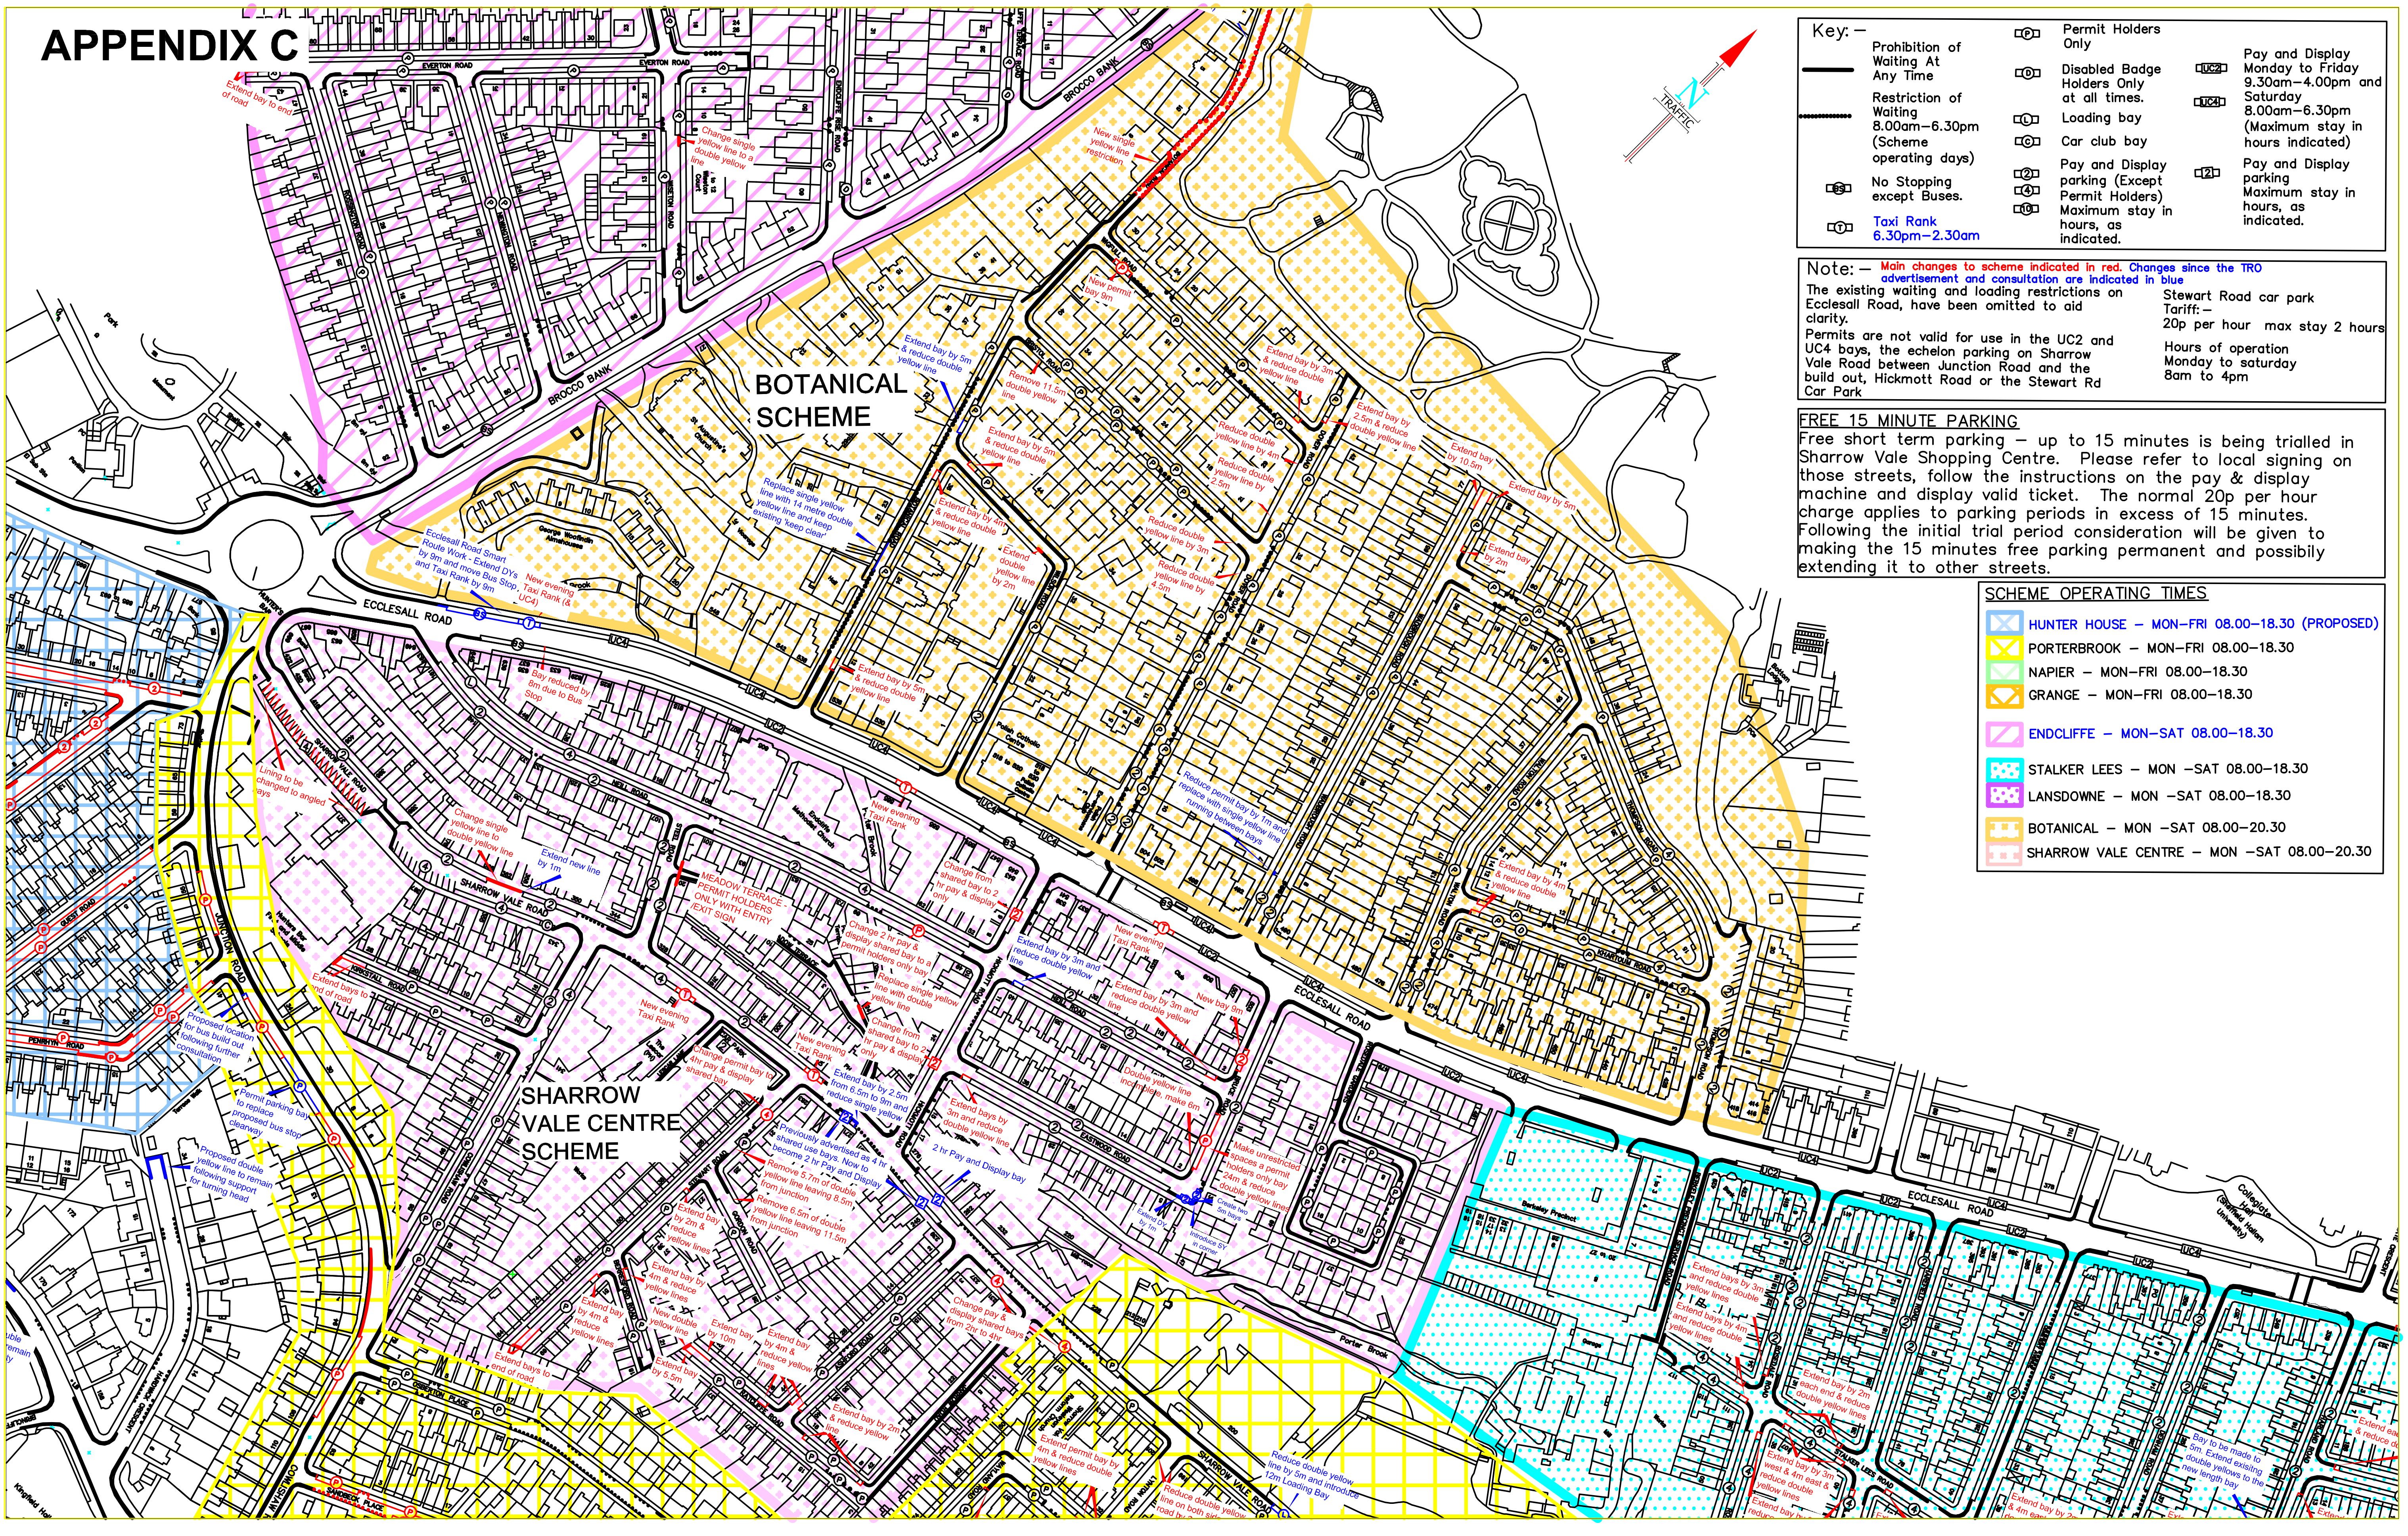

Key:–

- Prohibition of Waiting At Any Time
- Restriction of Waiting 8.00am–6.30pm (Scheme operating days)
- BS — No Stopping except Buses.
- T — Taxi Rank 6.30pm–2.30am
- P — Permit Holders Only
- D — Disabled Badge Holders Only at all times.
- L — Loading bay
- C — Car club bay
- 2, 4, 10 — Pay and Display parking (Except Permit Holders) Maximum stay in hours, as indicated.
- UC2, UC4 — Pay and Display Monday to Friday 9.30am–4.00pm and Saturday 8.00am–6.30pm (Maximum stay in hours indicated)
- 2 — Pay and Display parking Maximum stay in hours, as indicated.

Note: – Main changes to scheme indicated in red. Changes since the TRO advertisement and consultation are indicated in blue

The existing waiting and loading restrictions on Ecclesall Road, have been omitted to aid clarity.

Permits are not valid for use in the UC2 and UC4 bays, the echelon parking on Sharrow Vale Road between Junction Road and the build out, Hickmott Road or the Stewart Rd Car Park

Stewart Road car park
Tariff:–
20p per hour max stay 2 hours
Hours of operation
Monday to saturday
8am to 4pm

FREE 15 MINUTE PARKING

Free short term parking – up to 15 minutes is being trialled in Sharrow Vale Shopping Centre. Please refer to local signing on those streets, follow the instructions on the pay & display machine and display valid ticket. The normal 20p per hour charge applies to parking periods in excess of 15 minutes. Following the initial trial period consideration will be given to making the 15 minutes free parking permanent and possibly extending it to other streets.

SCHEME OPERATING TIMES

- HUNTER HOUSE – MON–FRI 08.00–18.30 (PROPOSED)
- PORTERBROOK – MON–FRI 08.00–18.30
- NAPIER – MON–FRI 08.00–18.30
- GRANGE – MON–FRI 08.00–18.30
- ENDCLIFFE – MON–SAT 08.00–18.30
- STALKER LEES – MON –SAT 08.00–18.30
- LANSDOWNE – MON –SAT 08.00–18.30
- BOTANICAL – MON –SAT 08.00–20.30
- SHARROW VALE CENTRE – MON –SAT 08.00–20.30

ON STREET PAY & DISPLAY TARIFF

Up to 1 hour - 20p
Up to 2 hours - 40p
Up to 3 hours - 60p
Up to 4 hours - 80p
Up to 10 hours - £2.00

Rev	Date	Content	Signed
		Sharrow Vale Road – 2hr bays, pay and display only. Advertise through an ETRO	
		Botanical Road – Extension of bay to be advertised through new TRO	
		Neill Road and Eastwood Road – proposed extensions of bays have been removed where DYs are considered necessary. An extra bay has been proposed which will require a new TRO	
		The proposed Taxi Ranks on Ecclesall Road shown on this plan are to remain	
		Ecclesall Road Smart Route – Bus Stop and Taxi rank near Hunters Bar to move 9m inbound	

DRAWING NO. TR-BG259-R2

DEVELOPMENT SERVICES
TRANSPORT & HIGHWAYS DIVISION
TRAFFIC SECTION
2-10 CARBROOK HALL ROAD
SHEFFIELD S9 2DB
E-mail Traffic.Regs@Sheffield.gov.uk
Director: L Sturch M.R.T.P.I.
Development Services
A Service Area of the Directorate of Place
Sheffield City Council

- Do not scale from this drawing
- Any errors/omissions to be reported immediately
- If in doubt, ask
- This drawing is based upon Ordnance Survey material with the permission of Ordnance Survey on behalf of the Controller of Her Majesty's Stationery Office. © Crown Copyright. Unauthorised reproduction infringes Crown copyright and may lead to prosecution or civil proceedings. 100018816. 2010

DRAWN: LE, JUNE 2010
CHECKED:
Notes

Client: SHEFFIELD CITY COUNCIL
Scheme: Sharrow Vale Permit Parking Scheme Review
Drawing Title: Sharrow Vale Centre & Botanical Scheme 7 of 8
Drawing No. TR-BG259-R2
Scale: 1 / 1250 A1
Date: June 2010

Sheffield City Council — Development Environment & Leisure — DEVELOPMENT SERVICES

CAD FILE NAME: G:\DEL\DS\Traff-Regs\SCHEME FILES\PERMIT PARKING ZONES\Sharrowvale\TR-16-6017-BG259\CAD\Review Drawing 2009\Stage 2 Review Minor and Zone Changes Drawings