


APPENDIX C

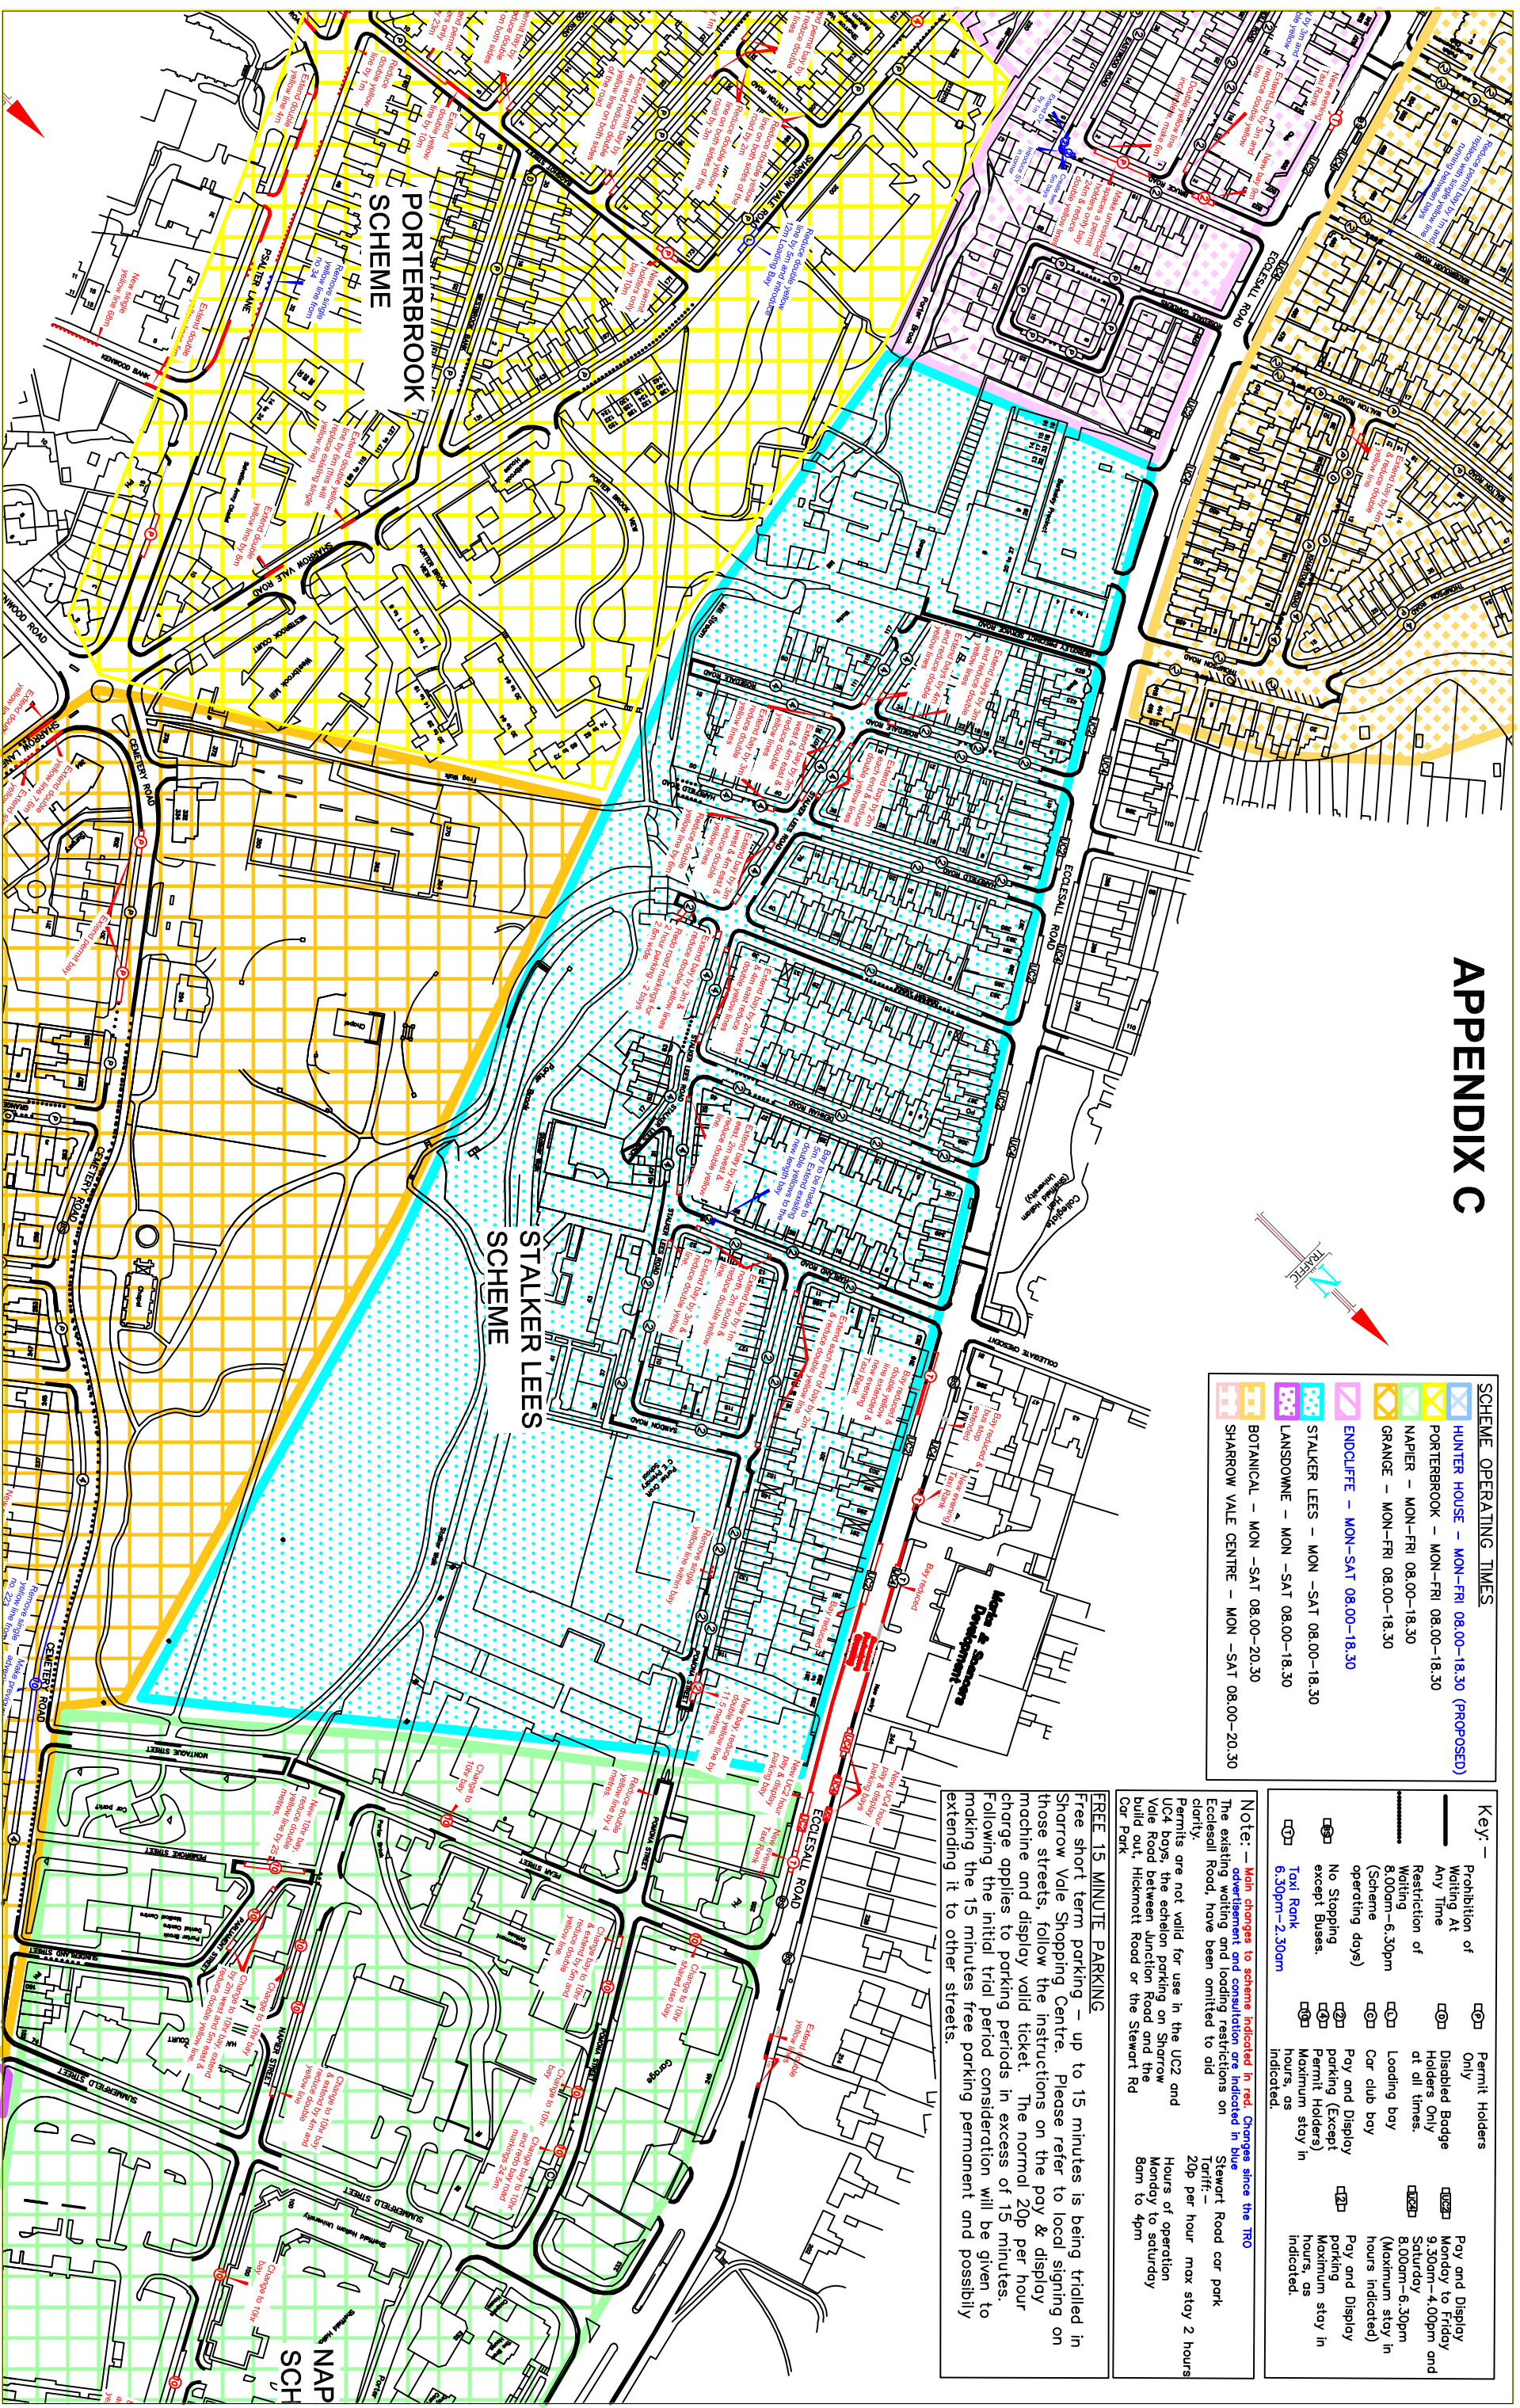

SCHEME OPERATING TIMES

	HUNTER HOUSE - MON-FRI 08.00-18.30 (PROPOSED)
	PORTERBROOK - MON-FRI 08.00-18.30
	NAPIER - MON-FRI 08.00-18.30
	GRANICE - MON-FRI 08.00-18.30
	ENDCLIFFE - MON-SAT 08.00-18.30
	STALKER LEES - MON-SAT 08.00-18.30
	LANSOWNE - MON-SAT 08.00-18.30
	BOTANICAL - MON-SAT 08.00-20.30
	SHARROW VALE CENTRE - MON-SAT 08.00-20.30

Key:

	Prohibition of Waiting At Any Time
	Restriction of Waiting 8.00am-6.30pm (Scheme operating days)
	No Stopping except Buses.
	Taxi Rank 6.30pm-2.30am
	Permit Holders Only
	Disabled Badge Holders Only at all times.
	Loading bay
	Car club bay
	Pay and Display parking (except Permit Holders) Maximum stay in hours as indicated.
	Pay and Display Monday to Friday 9.30am-4.00pm and Saturday 8.00am-6.30pm (Maximum stay in hours indicated)

Note: - Main changes to scheme indicated in red. Changes since the TR0 advertisement and consultation are indicated in blue.

The existing waiting and loading restrictions on Ecclesall Road, have been omitted to aid clarity.

Permits are not valid for use in the UC2 and UC4 bays, the ejection parking on Sharrow Vale Road between Junction Road and the build out, Hickmott Road or the Stewart Rd Car Park.

FREE 15 MINUTE PARKING

Free short term parking - up to 15 minutes is being trialled in Sharrow Vale Shopping Centre. Please refer to local signage on those streets. Follow the instructions on the pay & display machine and display valid ticket. The normal 20p per hour charge applies to parking periods in excess of 15 minutes. Following the initial trial period consideration will be given to making the 15 minutes free parking permanent and possibly extending it to other streets.

DEVELOPMENT SERVICES
TRANSPORT & HIGHWAYS DIVISION
TRAFFIC SECTION
1 TRAFALGAR ROAD
SHEFFIELD S9 2BB
Email: traffic@sheffield.gov.uk
Development Services

TRAFFIC ENGINEER
A. J. B. BROWN
A. Service Area of the Directorate of Place
Sheffield City Council

DATE
JUNE 2010

LE
CHECKED
JUNE 2010

Notes

- Do not scale from this drawing
- Any errors/omissions to be reported immediately
- If in doubt, ask
- This drawing is based upon Ordnance Survey material with the permission of Ordnance Survey on behalf of the Controller of Her Majesty's Stationery Office. Crown copyright and may be reproduced in any form whatsoever, subject to the above conditions.

ON STREET PAY & DISPLAY TARIFF

- Up to 1 hour - 20p
- Up to 2 hours - 40p
- Up to 3 hours - 60p
- Up to 4 hours - 80p
- Up to 10 hours - £2.00

Rev	Date	Content
1		The total rank proposed for outlets 290 and 297-291 removed

Client
SHEFFIELD CITY COUNCIL

Scheme
Sharrow Vale Permitting Parking Scheme Review

Drawing Title
Stalker Lees Scheme

Scale
1 / 1250

Date
June 2010

Drawing No.
TR-BG259-R2

Sheet
A1

6 OF 8

Sheffield City Council
Development Services