


APPENDIX C

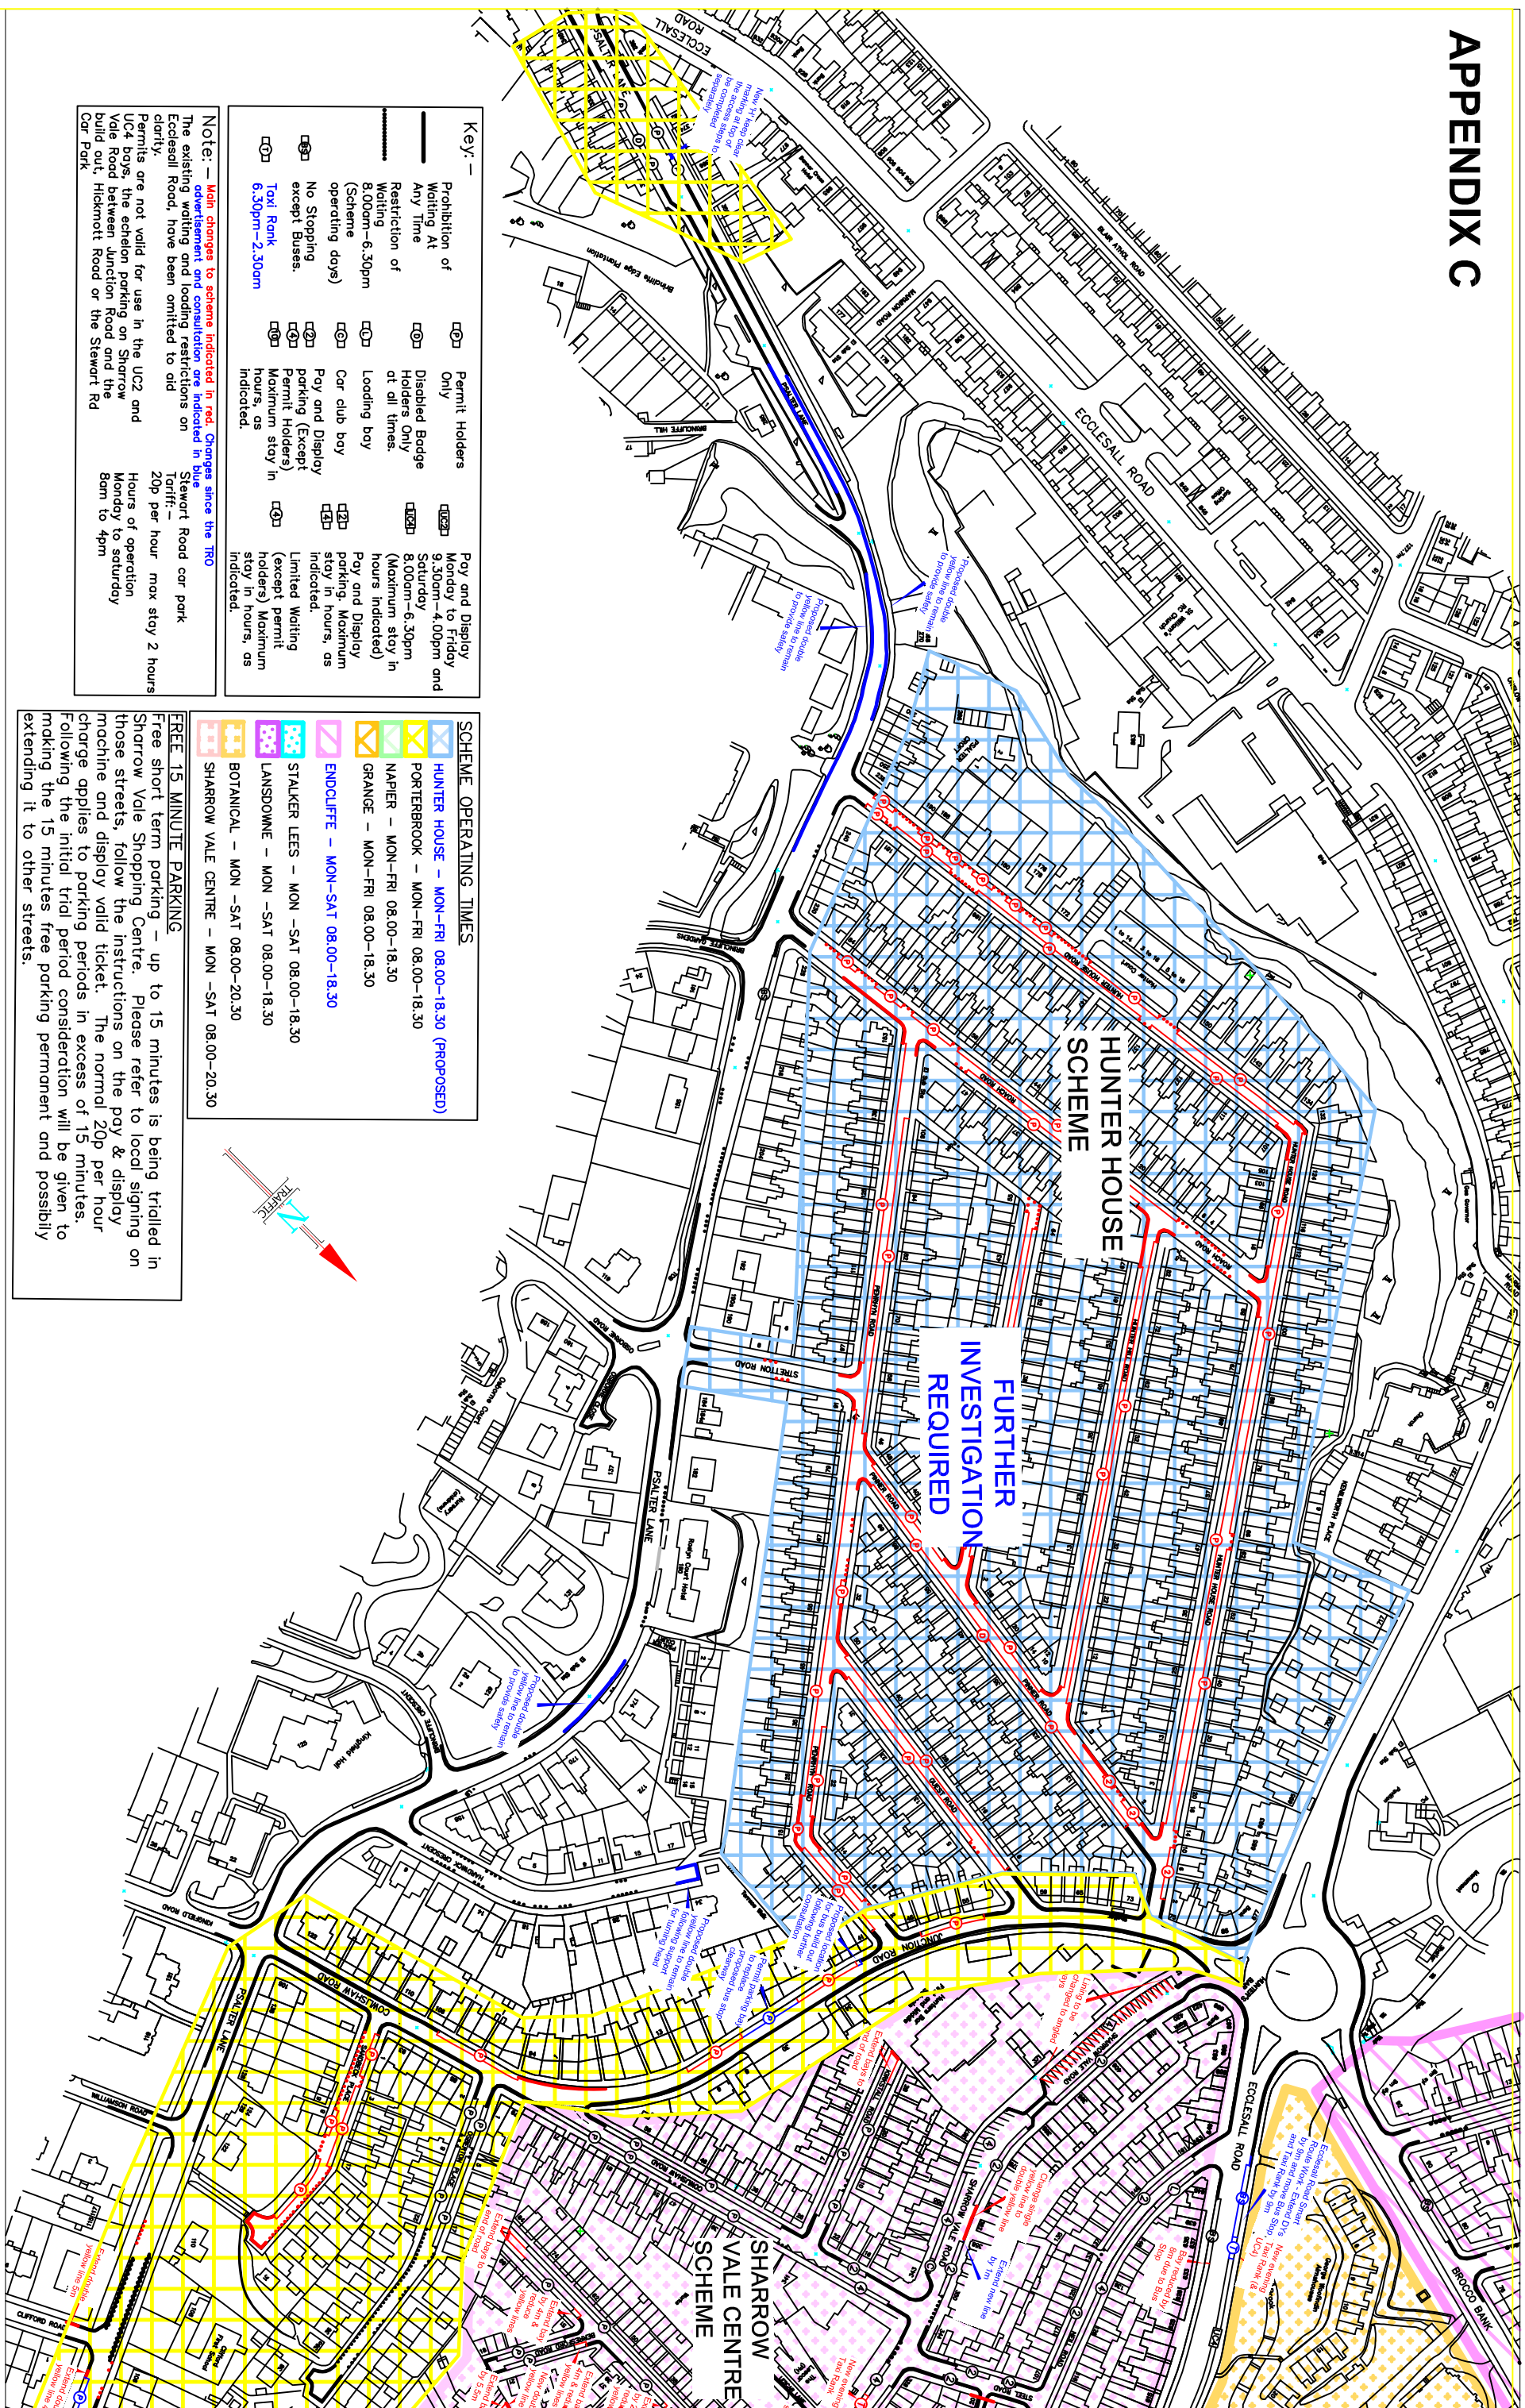

Key:

Prohibition of Waiting At Any Time	Permit Holders Only	Poy and Display Monday to Friday 9.30am-4.00pm and Saturday 8.00am-6.30pm (Maximum stay in hours indicated)
Restriction of Waiting 8.00am-6.30pm (Scheme operating days)	Disabled Badge Holders Only at all times	Car club boy Poy and Display parking (except Permit Holders) Maximum stay in hours, as indicated.
No Stopping except Buses	Loading boy	Limited Waiting (except permit holders) Maximum stay in hours, as indicated.
Taxi Rank 6.30pm-2.30am	Car club boy Poy and Display parking (except Permit Holders) Maximum stay in hours, as indicated.	

Note: - Main changes to scheme indicated in red. Changes since the TR0 advertisement and consultation are indicated in blue. The existing waiting and loading restrictions on Ecclesall Road have been omitted to aid clarity.

Permits are not valid for use in the UC2 and UC4 bays; the ejection parking on Sharrow Vale Road between Junction Road and the build out, Hickmott Road or the Stewart Rd Car Park.

SCHEME OPERATING TIMES

HUNTER HOUSE - MON-FRI 08.00-18.30 (PROPOSED)
PORTERBROOK - MON-FRI 08.00-18.30
NAPIER - MON-FRI 08.00-18.30
GRANGE - MON-FRI 08.00-18.30
ENDCLIFFE - MON-SAT 08.00-18.30
STALKER LEES - MON-SAT 08.00-18.30
LANSDOWNE - MON-SAT 08.00-18.30
BOTANICAL - MON-SAT 08.00-20.30
SHARROW VALE CENTRE - MON-SAT 08.00-20.30

FREE 15 MINUTE PARKING

Free short term parking - up to 15 minutes is being trialled in Sharrow Vale Shopping Centre. Please refer to local signing on those streets, follow the instructions on the pay & display machine and display valid ticket. The normal 20p per hour charge applies to parking periods in excess of 15 minutes. Following the initial trial period consideration will be given to making the 15 minutes free parking permanent and possibly extending it to other streets.















